


SYMBOL LEGEND	
	CONC. MONUMENT FND
	I.P. / I.B. FND
	TACK / STAKE FND
	WETLAND FLAG
	SPOT ELEVATIONS
	TRAFFIC SIGNAL POLE
	UTILITY POLE
	GUY WIRE
	LIGHT POLE
	SIGN
	FIRE HYDRANT
	BOLLARD
	ROOF DRAIN
	MONITORING WELL
	WELL
	MANHOLE
	"4" INLET
	"6" INLET
	"8" INLET
	YARD INLET
	FLARED END SECTION
	MAIL BOX
	CABLE TV BOX
	TELEPHONE BOX
	A/C UNIT
	TRANSFORMER
	ELECTRIC METER
	GAS METER
	WATER METER
	WATER VALVE
	GAS VALVE
	CLEAN OUT
	SPRINKLER HEAD
	GAS
	WATER
	ELECTRIC
	TELEPHONE
	CABLE TV
	TREE
	SHRUB
	D.C. DEPRESSED CURB
	L.S.A. LANDSCAPED AREA

GENERAL NOTES:

- THIS SURVEY IS NOT A BOUNDARY SURVEY. THE PURPOSE OF THIS SURVEY IS TO MAP POST FOUNDATION CONSTRUCTION AS-BUILT CONDITIONS. BOUNDARY INFORMATION IS SHOWN PER REFERENCE #1.
- THIS SURVEY IS SUBJECT TO ANY EASEMENTS OF RECORD AND OTHER PERTINENT FACTS THAT A COMPLETE TITLE SEARCH MIGHT DISCLOSE.
- THE PROJECT VERTICAL DATUM IS BASED ON REFERENCE #1.
- FIELD SURVEY PERFORMED ON NOVEMBER 14, 2014.
- THE UTILITIES SHOWN HAVE BEEN LOCATED FROM EVIDENCE OBSERVED ON THE SURFACE ONLY OR HAVE BEEN SHOWN GRAPHICALLY PER SUPPLIED MATERIALS. DPK CONSULTING MAKES NO GUARANTEES THAT THE UTILITIES SHOWN COMPRISE ALL SUCH UTILITIES IN THE AREA, EITHER IN-SERVICE OR ABANDONED. DPK CONSULTING FURTHER DOES NOT WARRANT THAT THE UNDERGROUND UTILITIES SHOWN ARE IN THE EXACT LOCATION INDICATED. DPK CONSULTING HAS NOT PHYSICALLY LOCATED THE UNDERGROUND UTILITIES.

MAP REFERENCES:

- MAP ENTITLED "SURVEY OF PROPERTY PREPARED FOR BLOCK 54, LOT 24.02 SITUATED IN THE TOWNSHIP OF HOWELL, MONMOUTH COUNTY, NEW JERSEY," PREPARED BY THOMAS J. ERTL & ASSOCIATES, LLC, DATED 03/25/04.

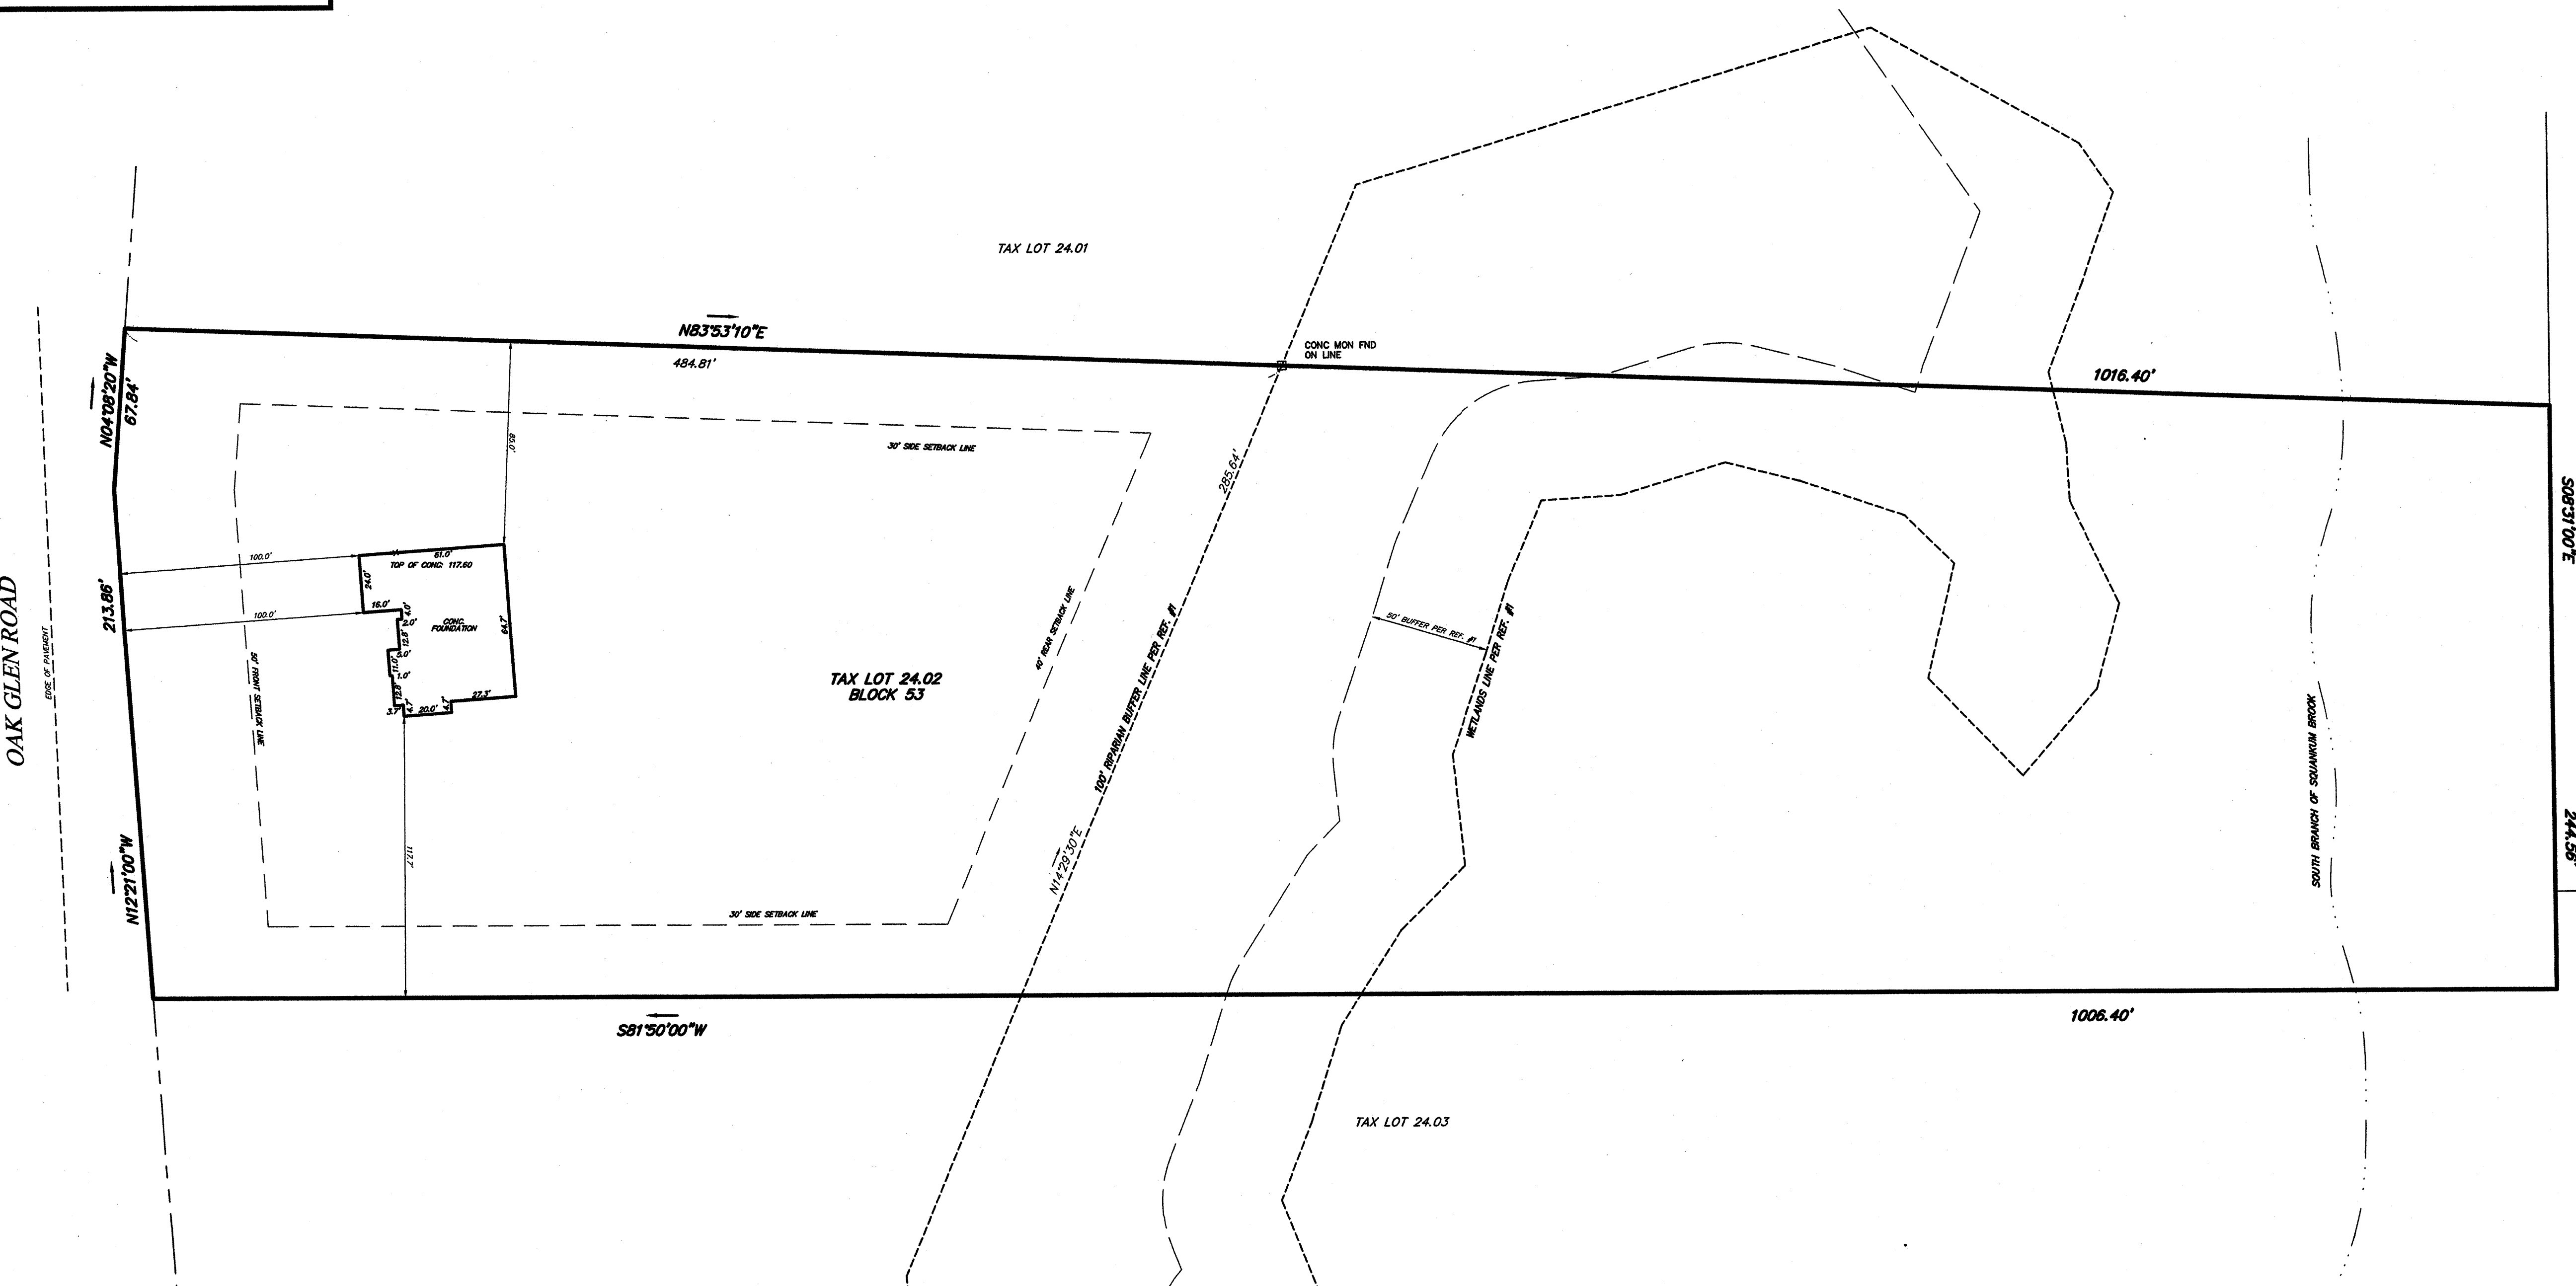

FOUNDATION AS-BUILT
TAX LOT 24.02
BLOCK 53
OAK GLEN ROAD
TOWNSHIP OF HOWELL
MONMOUTH COUNTY NEW JERSEY

SCALE: 1" = 40'
 DATE: 11/19/2014
 DRAWN BY: S.D.P.
 CHKD BY: S.D.P.

DPK CONSULTING
 147 Union Ave. Ste. 1C, Middletown, NJ 08846 P: 732-764-0100 F: 732-764-0990
 NEW JERSEY CERTIFICATE OF AUTHORIZATION NO. 24G22604200

Professional Land Surveyor
 N.J. Lic. 246503626900
 SPARENT@DPKCONSULTING.NET

REV	DATE	DESCRIPTION	BY	CHKD
	11.19.14			

DRAWING FILE: 14-6385FND00	1
PROJECT NUMBER: 14-6385	
1	1
REV. 0	